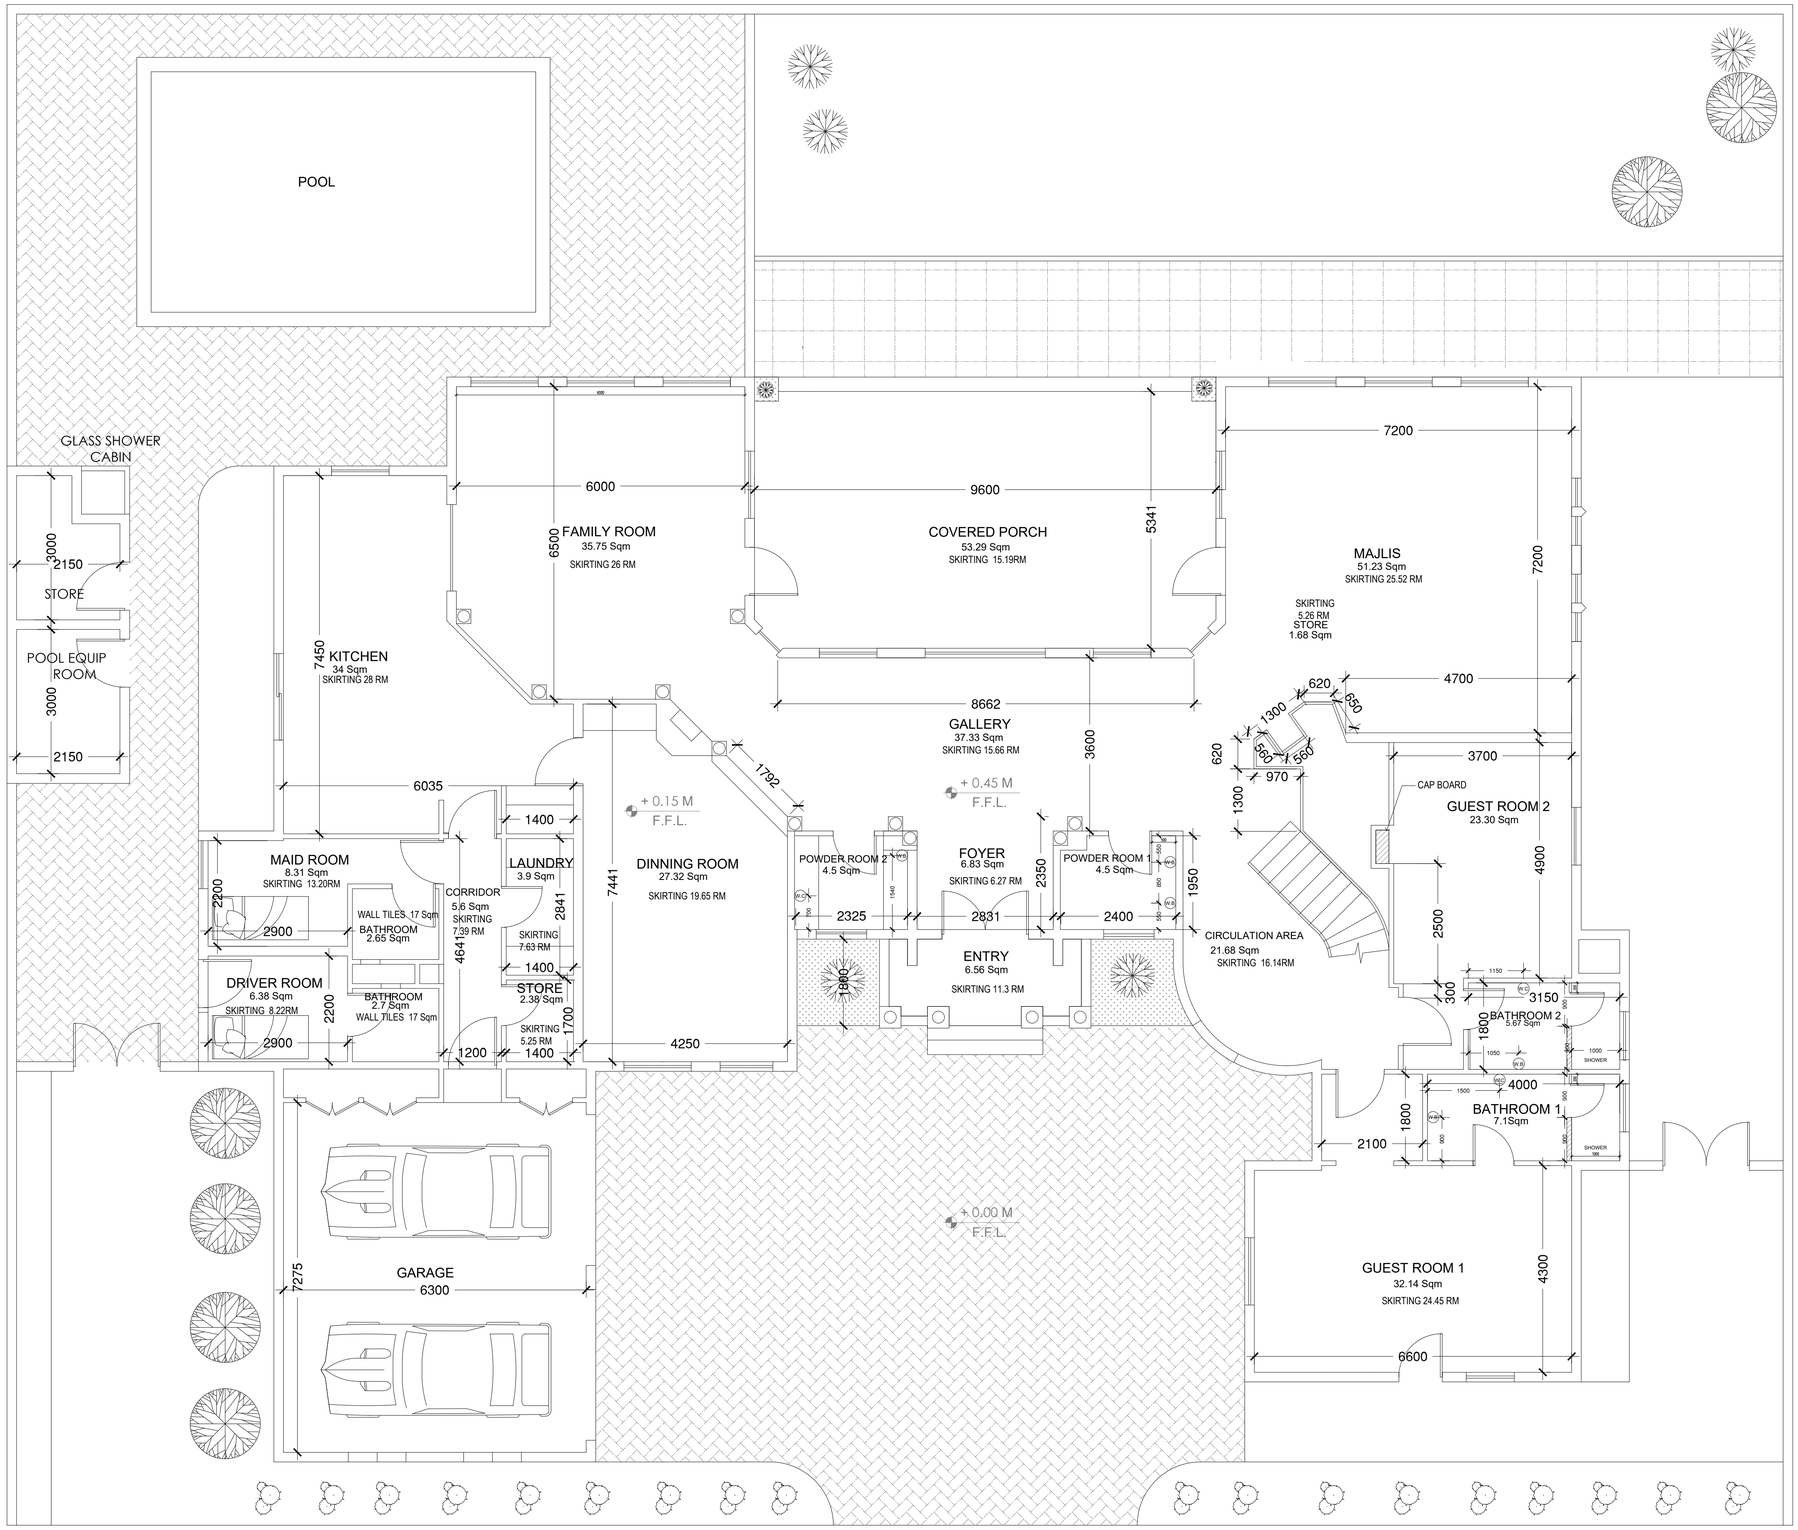

NOTES:

1. ALL DIMENSIONS ARE IN MILLIMETERS UNLESS NOTED OTHERWISE. DIMENSIONS SHALL NOT BE OBTAINED BY SCALING DRAWINGS.
2. ALL LEVELS ARE IN MILLIMETERS.
3. THIS DRAWING SHALL BE READ IN CONJUNCTURE WITH THE APPROVED MEP SHOP DRAWINGS.

S W E NORTH

REVIEW STATUS

A	APPROVED
B	APPROVED AS NOTED
C	REVISE and RESUBMIT
D	NOT APPROVED

REFERENCES

DRAWING NO.	DRAWING TITLE	REVISION

SUBMITTAL

REV.	DESCRIPTION	DATE	PREPARED	CHECKED

PROJECT:

G+1 VILLA

CLIENT:

MAIN CONSULTANT:

CONSULTANT:

A N T ENGINEERING CONSULTANTS
P O BOX 232606, DUBAI
TEL: (04) 2838490
TEL: (04) 2838490

MAIN CONTRACTOR:

TRANS FAST BUILDING CONTRACTING L.L.C
Tel:+971 45578560
P.O.BOX 60238, DUBAI,UAE
806 Al Saheel Tower 2, Al Nahda
www.transfastc.com

DRAWING TITLE:

GROUND FLOOR PLAN (AS BUILT)

DRAWN BY:	CHECKED BY:	APPROVED BY:	DATE:
WAQAR	28.09.2020	SHARAJ-A	28.09.2020
DRAWING NO.: TF-SD-CIV-PJ-21-001			REV NO: R0
SCALE:	SHEET: 1 of 2	SIZE: @A1	